

ITEM	QTY	P/N	DESCRIPTION
	X	D4470-041	AFT RIB ASSY (LH)
1	1	D4470-1	AFT RIB (LH)
2	4	MS20426AD3-5	RIVET, CSK
3	2	MS21069L08	NUTPLATE

D

D

C

C

B


B

A

A

## NOTES:


- 1) MATERIAL: N/A
- 2) FINISH: N/A
- 3) TOLERANCES: PER DART QSI 018 UNLESS OTHERWISE NOTED
- 4) UNITS: INCHES UNLESS OTHERWISE NOTED
- 5) BREAK SHARP EDGES: N/A
- 6) IDENTIFICATION: N/A
- 7) WEIGHT: 0.88 lbs

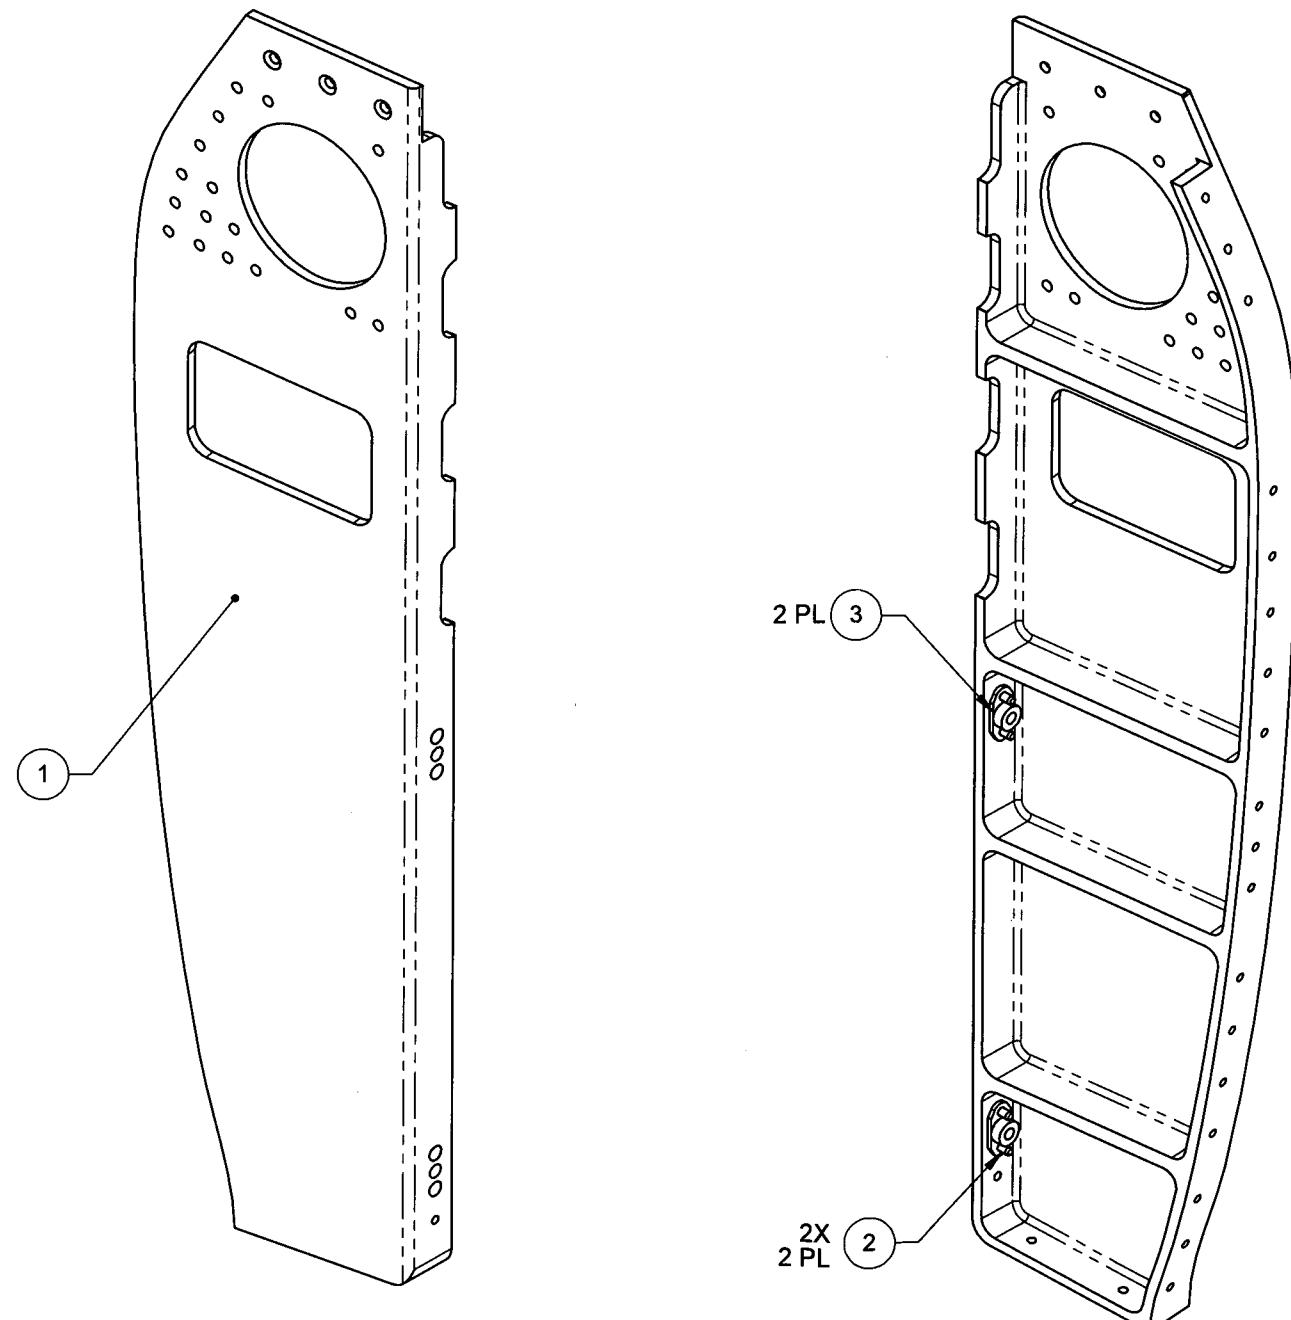

D4470-041 AFT RIB ASSY (LH)


C	SHEET 2 VIEW D-D NOTCHES EXPANDED. SHEET 5 VIEW H-H NOTCHES EXPANDED. REASON: LATCH MECHANISM RELOCATED AT NEXT ASSY, MODIFICATIONS DONE TO CLEAR NUTPLATES.		
B	COMPLETE REDESIGN SEE REV A FOR DETAILS. ADDED - 042 & -2 (RH CONFIGURATION). PRIMER NOTE ADDED FINISH.		
A	NEW ISSUE		
REV.	DESCRIPTION		
DESIGN	AJS	DART AEROSPACE LTD	
DRAWN	AJS	HAWKESBURY, ONTARIO, CANADA	
CHECKED	A.O.	DRAWING NO.	
MFG. APPR.	9/11	REV. C	
APPROVED	12/12	D4470	
DE APPR.	12/12	SHEET 1 OF 6	
DATE	12.12.12	TITLE	
		AFT RIB ASSY	
		SCALE	
		NTS	
		COPRIGHT © 2012 BY DART AEROSPACE LTD	
		THIS DOCUMENT IS PRIVATE AND CONFIDENTIAL AND IS SUPPLIED ON THE EXPRESS CONDITION THAT IT IS NOT TO BE USED FOR ANY PURPOSE OR COPIED OR COMMUNICATED TO ANY OTHER PERSON WITHOUT WRITTEN PERMISSION FROM DART AEROSPACE LTD.	

RELEASED  
2013-02-08  
MM

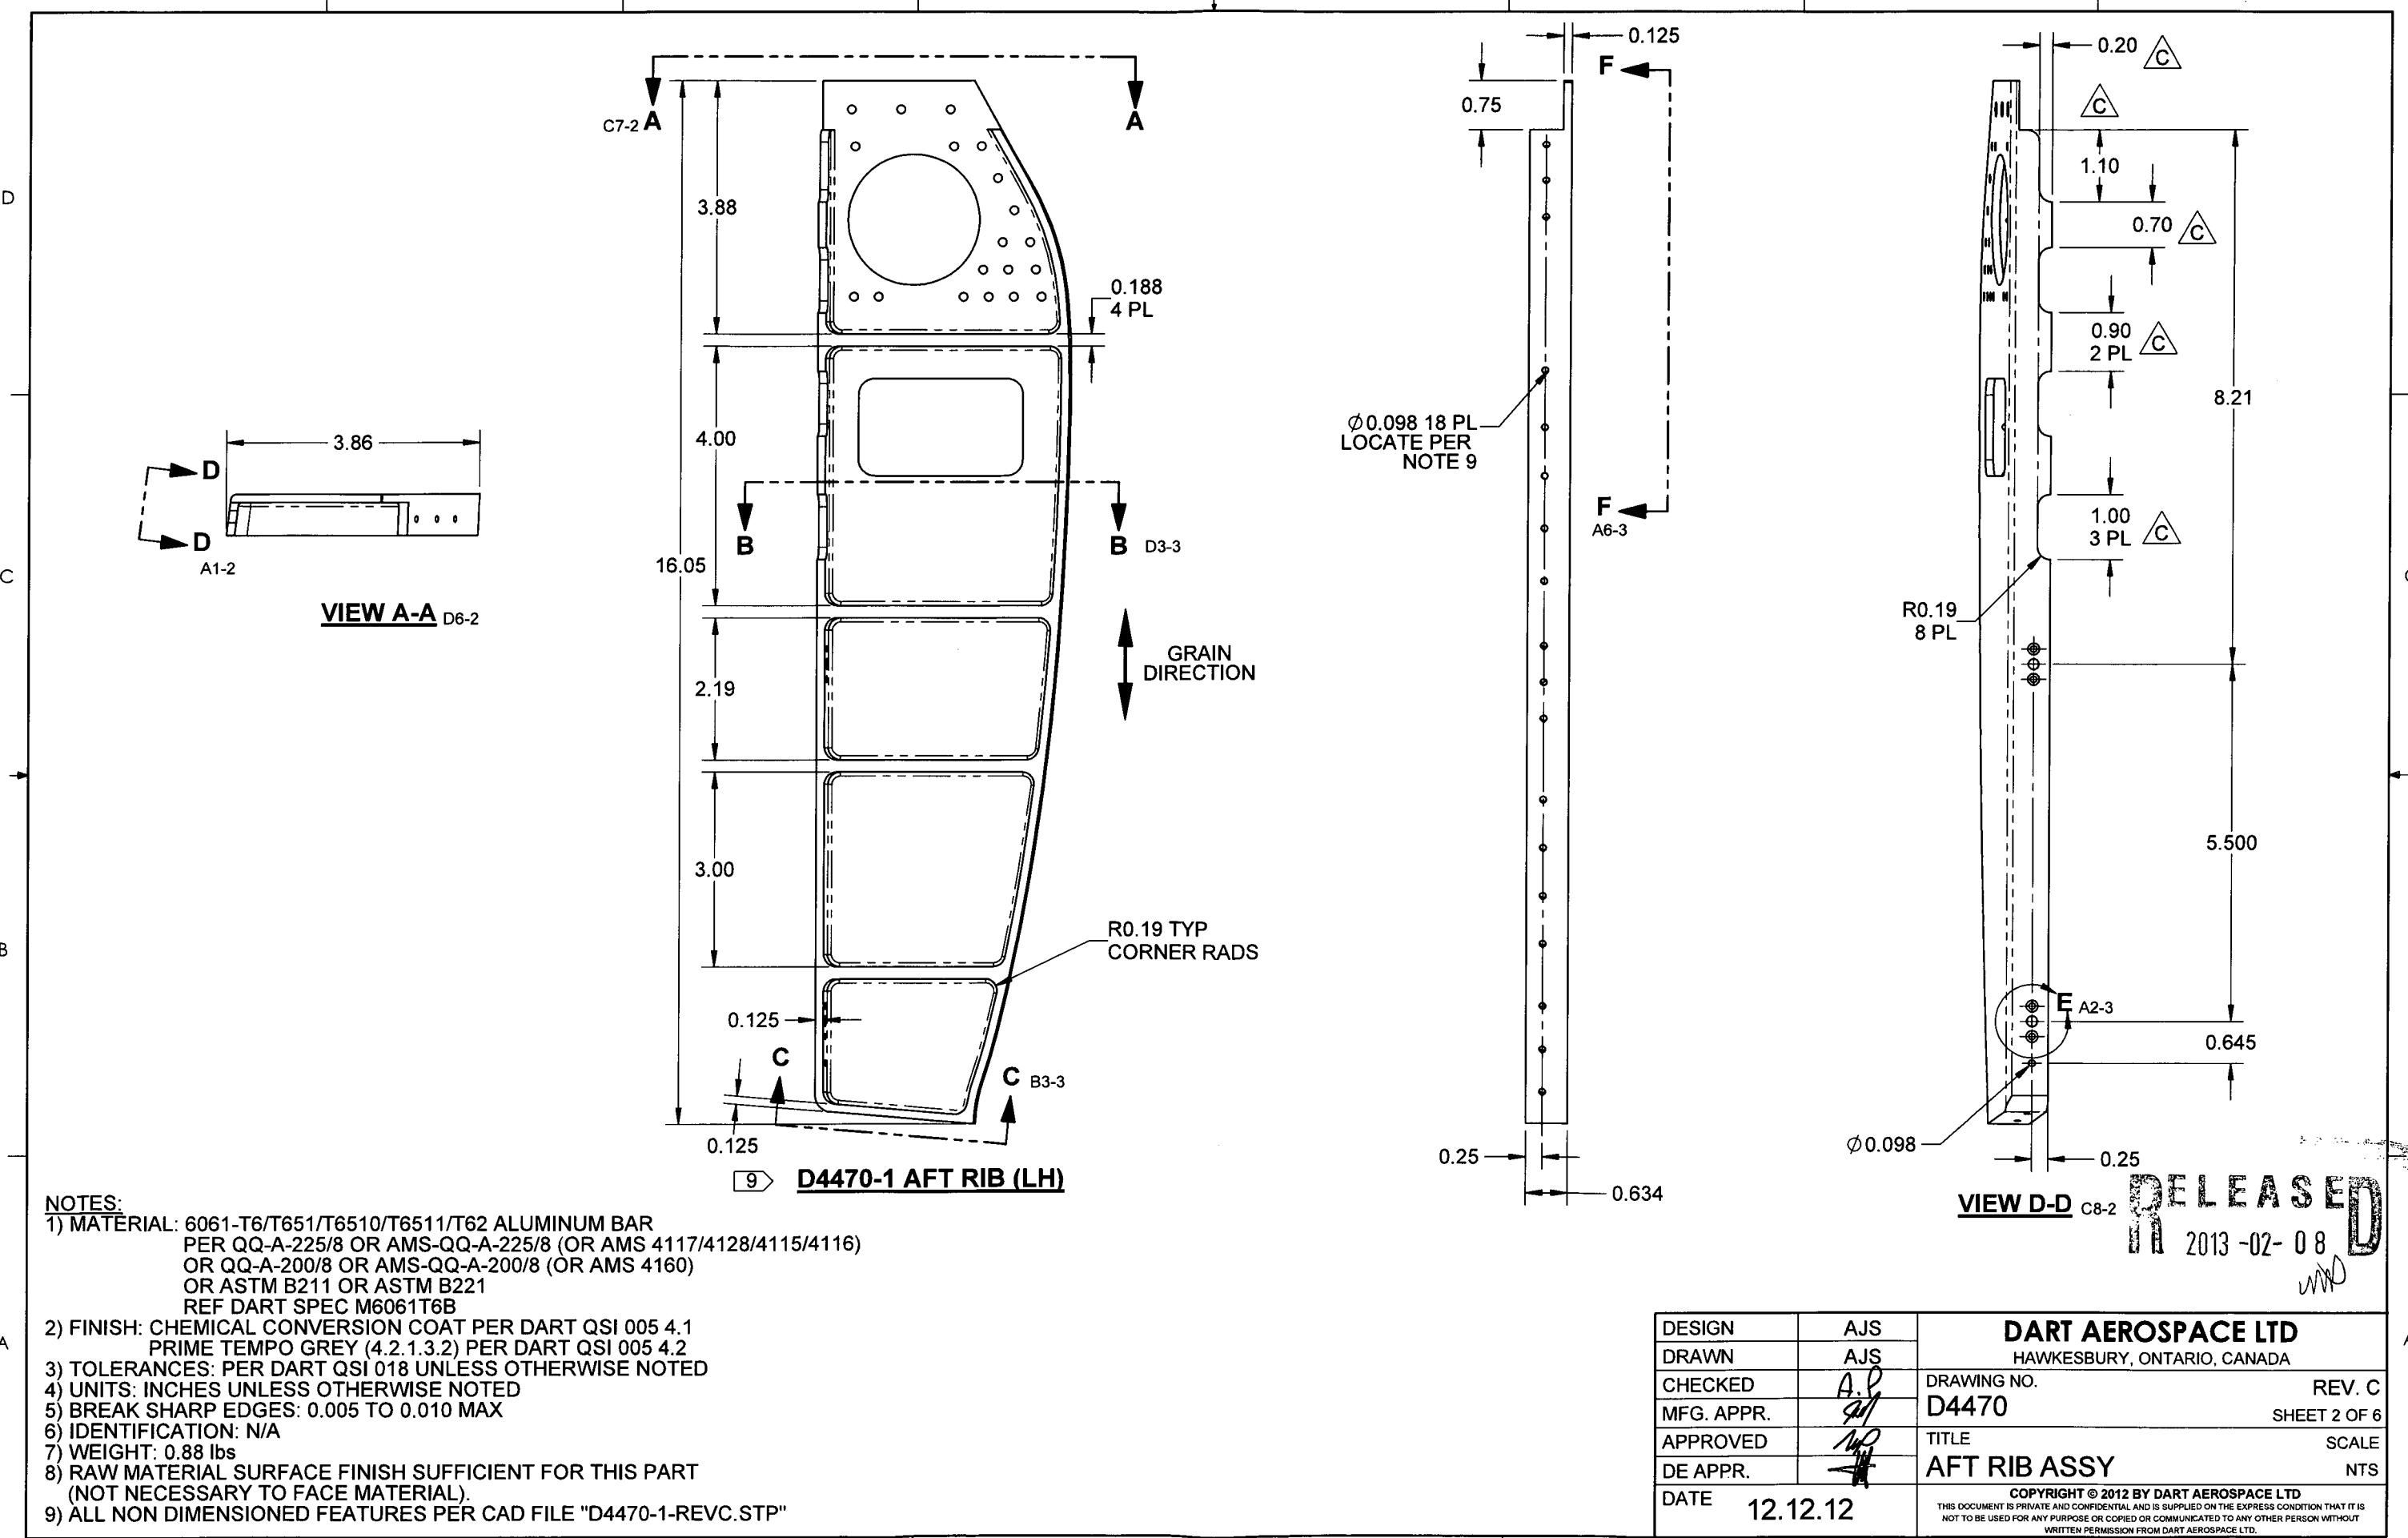

DESIGN	AJS	<b>DART AEROSPACE LTD</b> HAWKESBURY, ONTARIO, CANADA	
DRAWN	AJS		
CHECKED	<i>A. P</i>	DRAWING NO.	REV. C
MFG. APPR.	<i>SD</i>	D4470	SHEET 2 OF 6
APPROVED	<i>MP</i>	TITLE	SCALE
DE APPR.	<del><i>SD</i></del>	AFT RIB ASSY	NTS
DATE	12.12.12	<b>COPYRIGHT © 2012 BY DART AEROSPACE LTD</b>	
THIS DOCUMENT IS PRIVATE AND CONFIDENTIAL AND IS SUPPLIED ON THE EXPRESS CONDITION THAT IT IS NOT TO BE USED FOR ANY PURPOSE OR COPIED OR COMMUNICATED TO ANY OTHER PERSON WITHOUT			

ITEM	QTY	P/N	DESCRIPTION
	042		
X		D4470-042	AFT RIB ASSY (RH)
1	1	D4470-2	AFT RIB (RH)
2	4	MS20426AD3-5	RIVET, CSK
3	2	MS21069L08	NUTPLATE

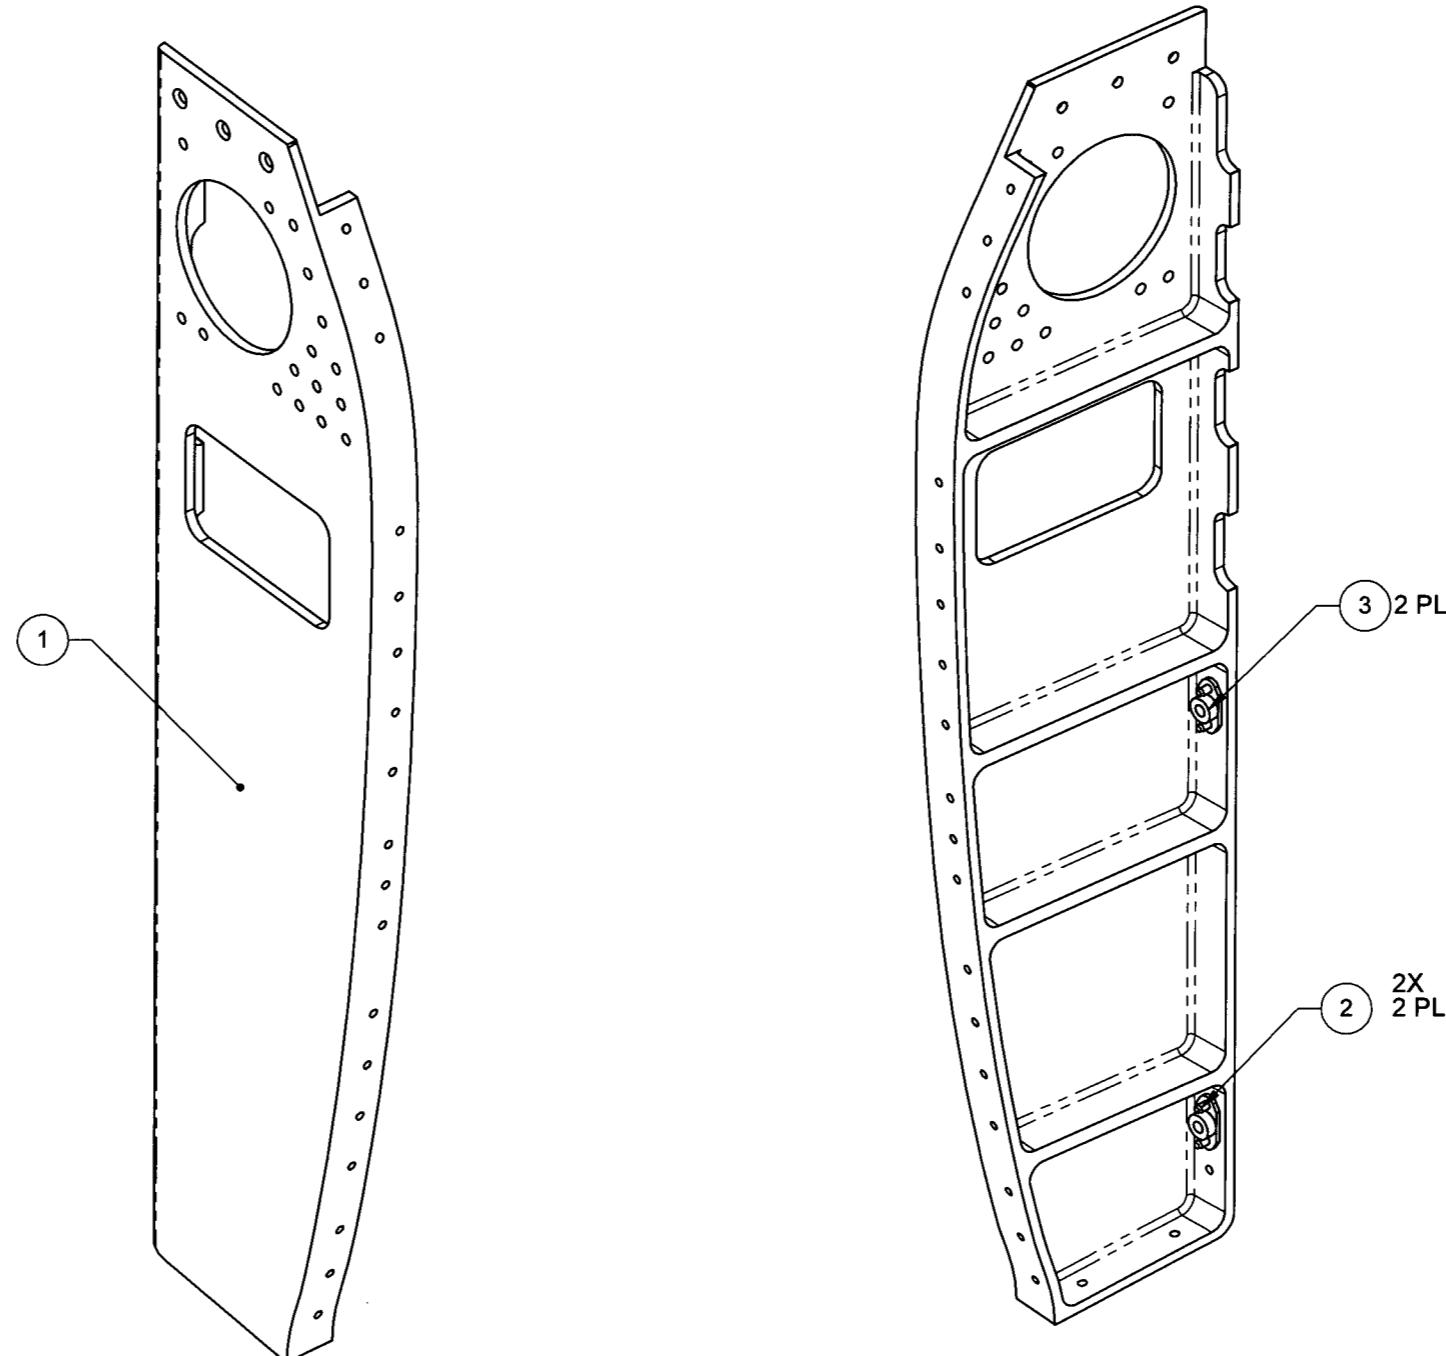


D4470-042 AFT RIB ASSY (RH)


NOTES:

- 1) MATERIAL: N/A
- 2) FINISH: N/A
- 3) TOLERANCES: PER DART QSI 018 UNLESS OTHERWISE NOTED
- 4) UNITS: INCHES UNLESS OTHERWISE NOTED
- 5) BREAK SHARP EDGES: N/A
- 6) IDENTIFICATION: N/A
- 7) WEIGHT: 0.88 lbs


DESIGN	AJS	<b>DART AEROSPACE LTD</b> HAWKESBURY, ONTARIO, CANADA
DRAWN	AJS	
CHECKED	A. P.	
MFG. APPR.	QH	
APPROVED	W.O.	
DE APPR.	W.O.	
DATE	12.12.12	

DRAWING NO. D4470 REV. C  
SHEET 4 OF 6  
TITLE AFT RIB ASSY  
SCALE NTS  
COPRIGHT © 2012 BY DART AEROSPACE LTD  
THIS DOCUMENT IS PRIVATE AND CONFIDENTIAL AND IS SUPPLIED ON THE EXPRESS CONDITION THAT IT IS NOT TO BE USED FOR ANY PURPOSE OR COPIED OR COMMUNICATED TO ANY OTHER PERSON WITHOUT WRITTEN PERMISSION FROM DART AEROSPACE LTD.

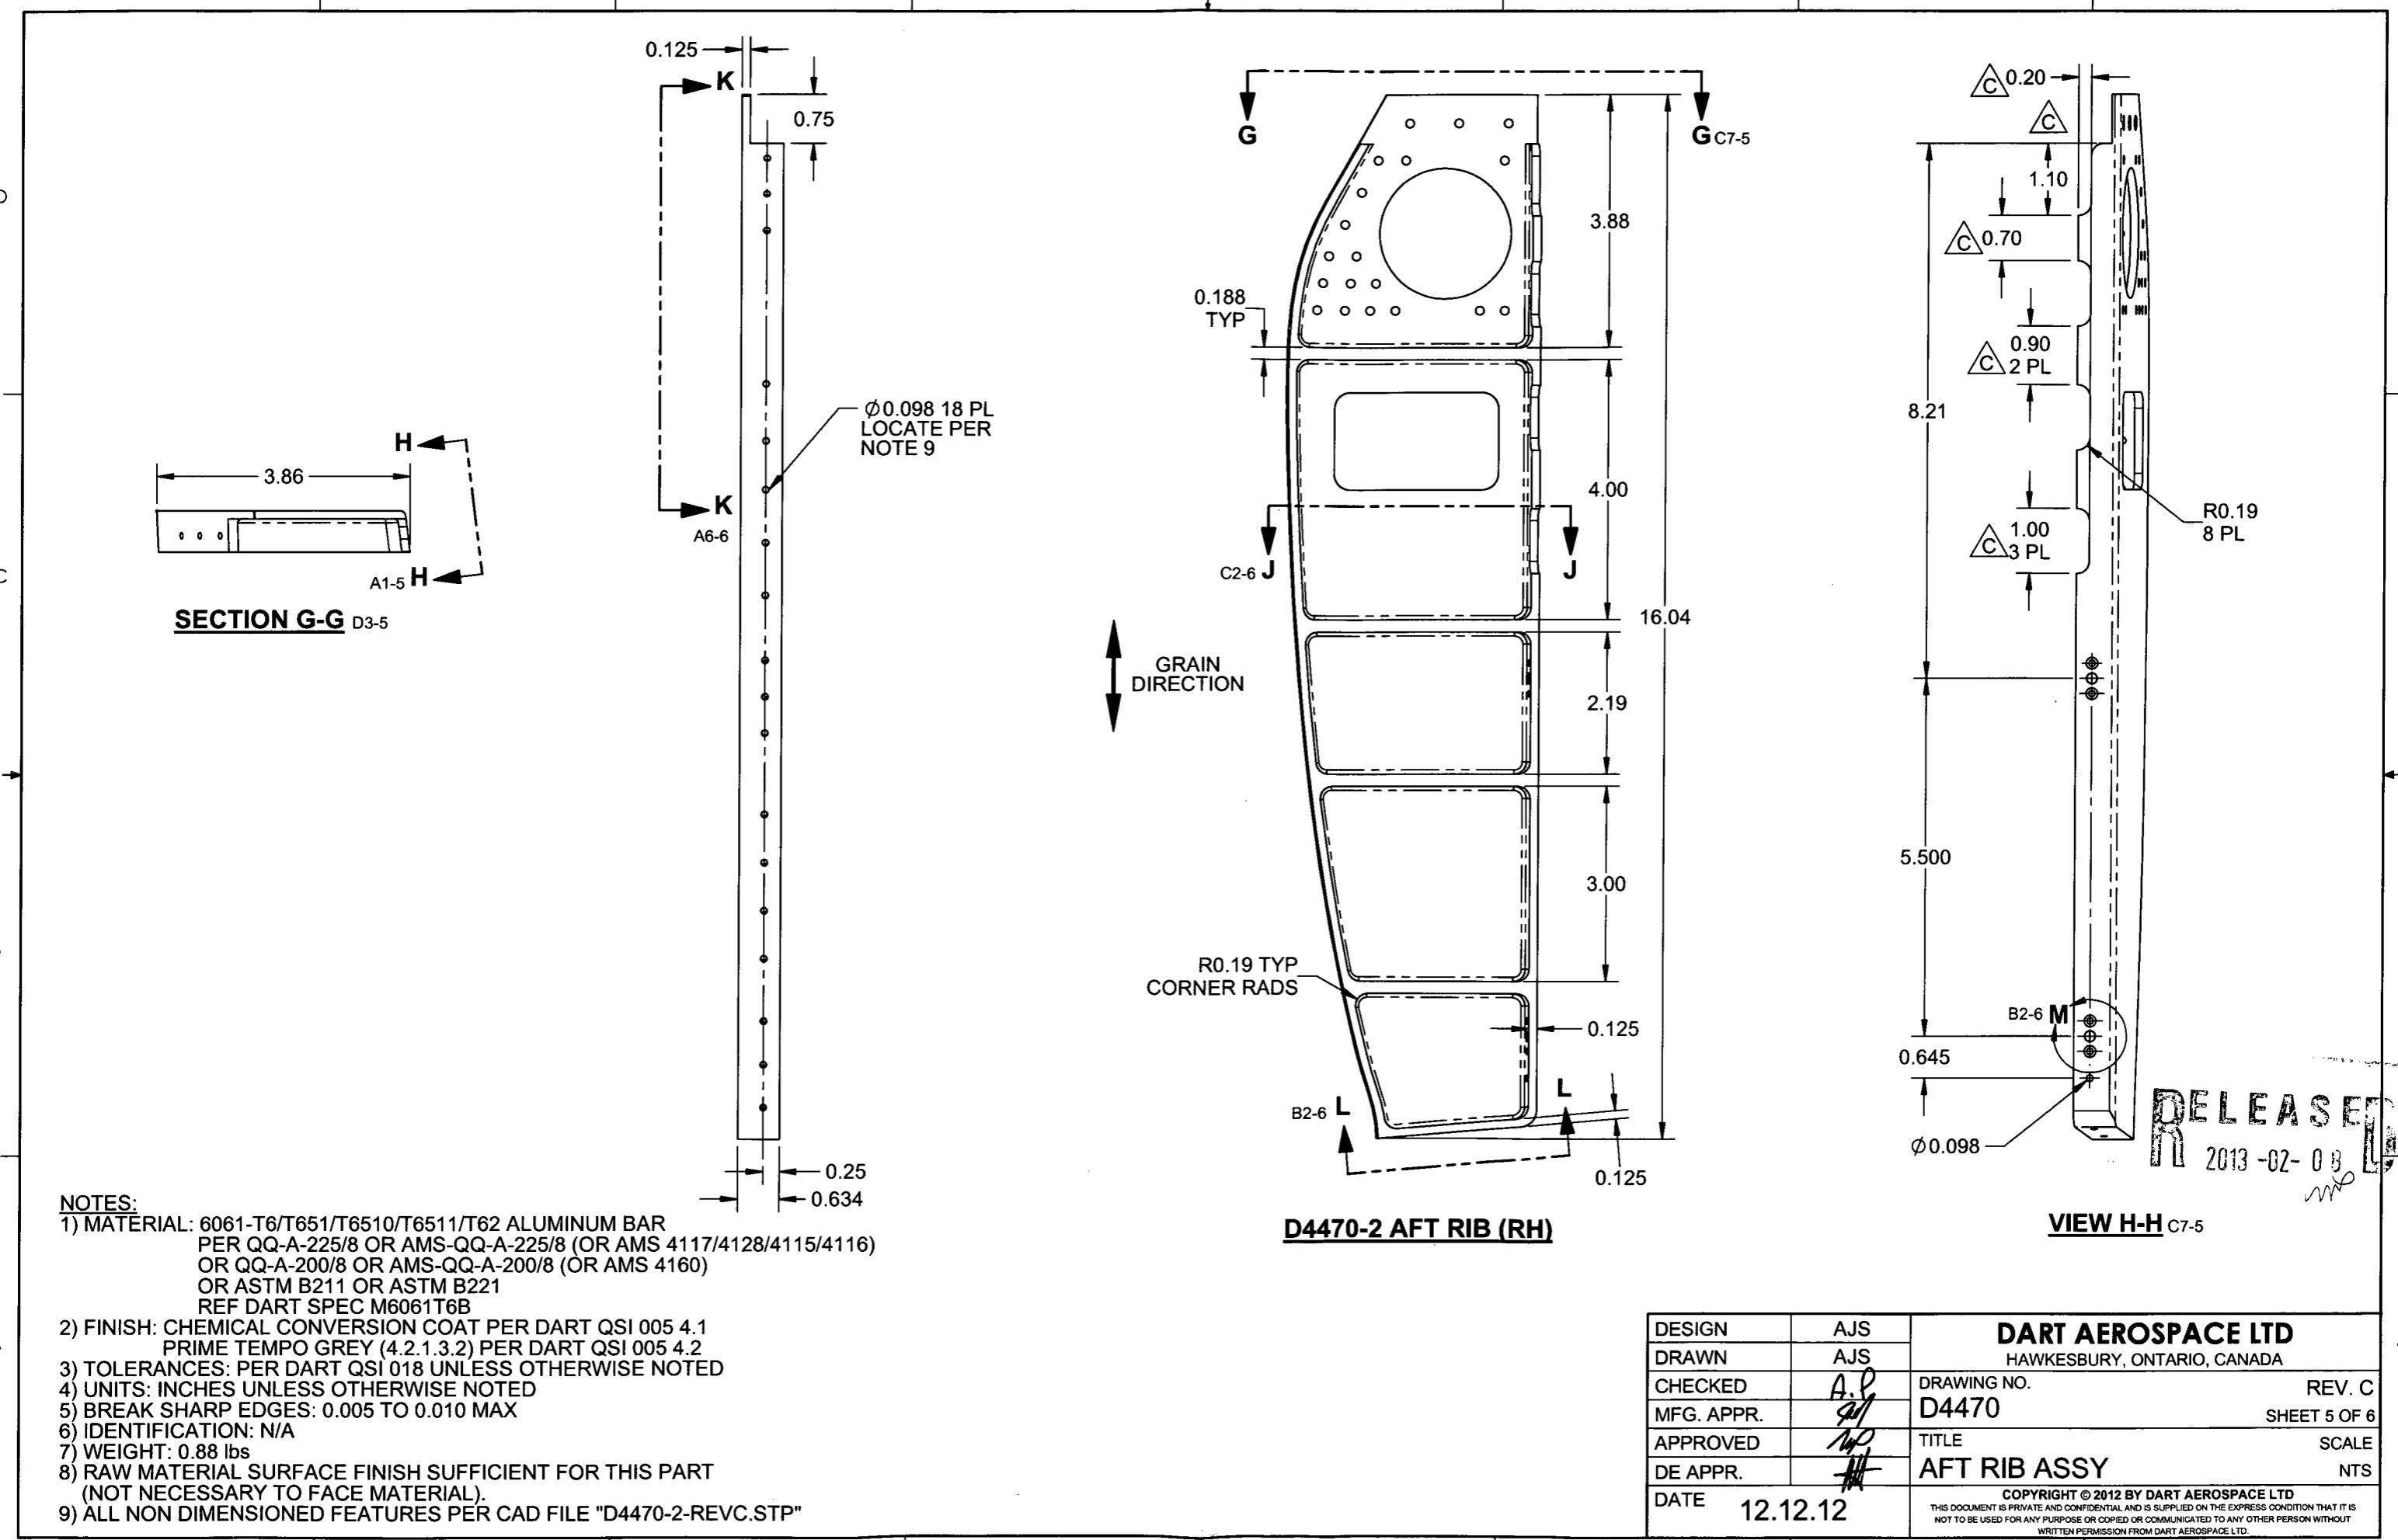


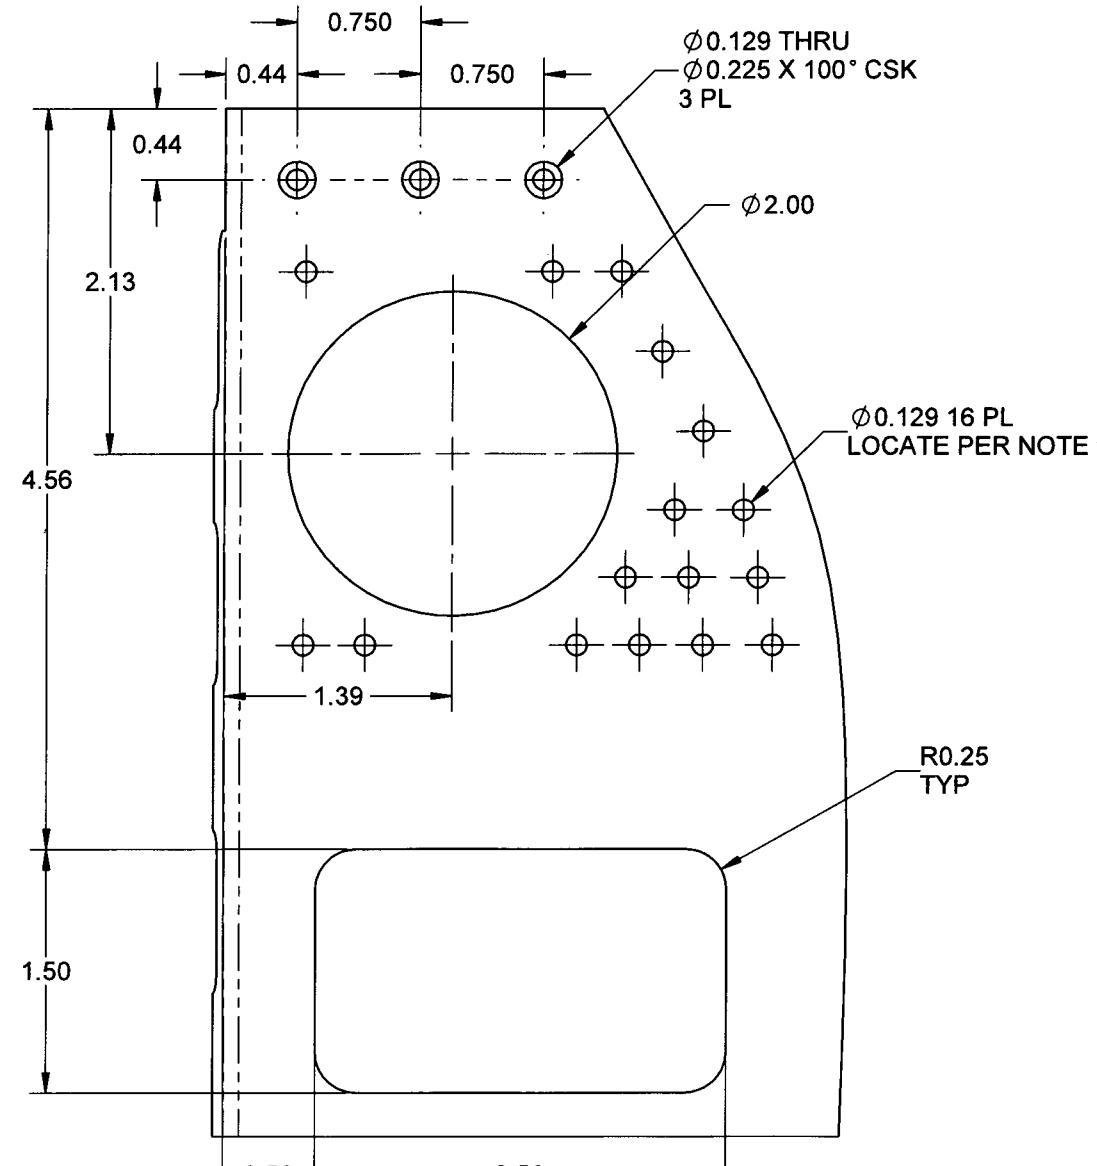


**SECTION K-K** C6-5  
SCALE 2X

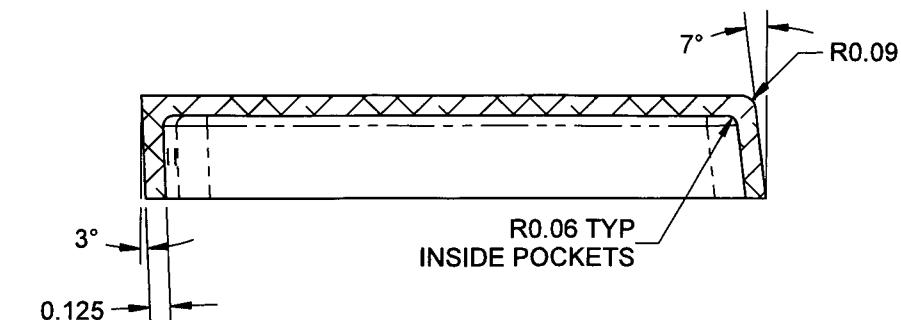

**SECTION J-J** C4-5  
SCALE 2X

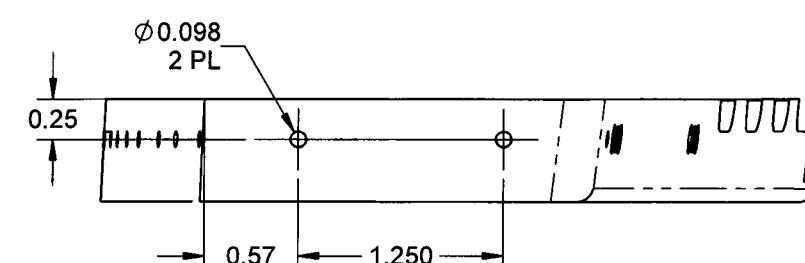

**VIEW L-L** B4-5  
**SCALE 2X**

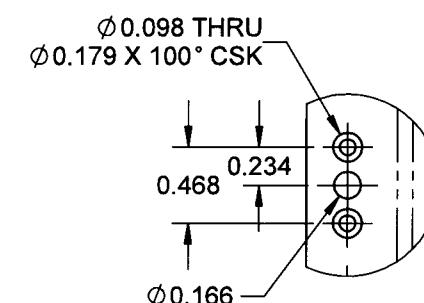

**DETAIL M** B2-5  
NUTPLATE HOLE DETAIL 2 PL  
SCALE 2X

DESIGN	AJS	<b>DART AEROSPACE LTD</b> HAWKESBURY, ONTARIO, CANADA	
DRAWN	AJS		
CHECKED	<i>A.D.</i>	DRAWING NO.	REV. C
MFG. APPR.	<i>Sett</i>	D4470	SHEET 6 OF 6
APPROVED	<i>MJ</i>	TITLE	SCALE
DE APPR.	<del><i>MJ</i></del>	AFT RIB ASSY	NTS
DATE	12.12.12	COPYRIGHT © 2012 BY DART AEROSPACE LTD THIS DOCUMENT IS PRIVATE AND CONFIDENTIAL, AND IS SUPPLIED ON THE EXPRESS CONDITION THAT IT IS NOT TO BE USED FOR ANY PURPOSE OR COPIED OR COMMUNICATED TO ANY OTHER PERSON WITHOUT <a href="http://www.dart aerospace.com">HTTP://WWW.DARTAEROSPACE.COM</a>	

**COPYRIGHT © 2012 BY DART AEROSPACE LTD**  
THIS DOCUMENT IS PRIVATE AND CONFIDENTIAL AND IS SUPPLIED ON THE EXPRESS CONDITION THAT IT IS  
NOT TO BE USED FOR ANY PURPOSE OR COPIED OR COMMUNICATED TO ANY OTHER PERSON WITHOUT  
WRITTEN PERMISSION FROM DART AEROSPACE LTD.